

INVOICE

DON ALLEN AND ASSOCIATES, PA
127 Promenade Dr Ste E
Mooresville, NC 28117

quotes@donallensurvey.com
704 664-7029



PATEL, CHAMPAK: LOT 29 B.L. KISER - 4673 KISER ISLAND RD

Bill to

CHAMPAK PATEL
CHAMP52@HOTMAIL.COM

Ship to

LOT 29 B.L. KISER - 4673 KISER ISLAND
RD
CHAMPAK PATEL

Invoice details

Job Name: LOT 29 B.L. KISER

Invoice no.: 38478447
Terms: Due on receipt
Invoice date: 06/11/2024
Due date: 06/11/2024

#	Date	Product or service	Description	Qty	Rate	Amount
1.		LAKE PHYSICAL	LAKE PHYSICAL SURVEY (WITH MAP) - MARK PROPERTY CORNERS & LOCATE EXISTING IMPROVEMENTS	1	\$825.00	\$825.00
2.			(DOES NOT INCLUDE STAKING BOUNDARY LINES, STAKING LAKE BUFFER, OR LOCATING UNDERGROUND UTILITIES)			
3.			**COMPLETED SURVEY DUE DATE: 06.28.24			
4.			(Please pay invoice by 3:00pm on Wednesday, June 12th to keep due date of June 28th. D.A.S. has begun booking into the week of July 1st.)			

Ways to pay



Total	\$825.00
Payment	-\$825.00
Balance due	\$0.00

Note to customer

ADDRESS: 4673 KISER ISLAND RD TERRELL, NC 28682

We received your agreement! Please provide payment through the QuickBooks payment link if you would like to proceed with scheduling. We are currently booking into the week of June 24th for field work. A confirmation email with a tentative schedule date once your payment has been received. Please contact our office if you have any questions regarding payments or scheduling.

Paid in Full

FLOOD STATEMENT

Re: Lot 29 B.L. Kiser Subdivision No.3 & Additional Parcel
4673 Kiser Island Road
Terrell, NC 28682
Champak Patel & Suman Patel

According to FEMA's Flood Insurance Rate Map is the above referenced property located in a special hazard area.


- () - No-property not in flood
- (x) - Yes- Up to flood line as shown
- () - Above mentioned map not available

Comments:

William M. Allen

June 27, 2024

Date

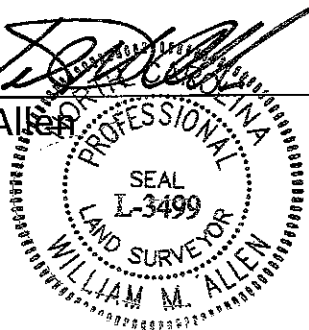



SURVEYOR'S REPORT FORM

To: INVESTORS TITLE INSURANCE COMPANY

THIS IS TO CERTIFY, that on June 27, 2024, I made an accurate survey of the premises standing in the name of Champak Patel & Suman Patel situated at Mountain Creek TWSP (CITY), Catawba (COUNTY), NC (STATE) briefly described as Lot 29 B.L. Kiser Subdivision No.3 & Additional Parcel and shown on the accompanying survey entitled: Physical Survey.


I made a careful inspection of said premises and of the buildings located thereon at the time of making such survey, and again on June 27, 2024, and at the time of such latter inspection I found Champak Patel & Suman Patel to be in possession of said premises as purchaser (TENANT) OR (OWNER).

I further certify as to the existence or non-existence of the following at the time of my last inspection:

1. Rights of way, old highways, or abandoned roads, lanes or driveways, drains, sewer, water, gas or oil pipe lines across said premises: None
2. Springs, streams, rivers, ponds, or lakes located, bordering on or running through said premises: As shown
3. Cemeteries or family burying grounds located on said premises. (Show location on plat): None
4. Telephone, telegraph or electric power poles, wires or lines overhanging or crossing or located on said premises and serving said premises or other property or properties: As shown
5. Joint driveways or walkways; party walls or rights of support; porches, steps or roofs used in common or joint garages: None
6. Encroachments, or overhanging projections. (If the buildings, projections or cornices thereof, or signs affixed thereto, fences or other indications of occupancy encroach upon or overhang adjoining properties, or the like encroach upon or overhang surveyed premises, specify all such): Covered concrete pad encroaches up to 8.7' as shown & Covered concrete pad encroaches up to 1.2' as shown
7. Building or possession lines. (In case of city or town property specify definitely as to whether or not walls are independent walls or party walls and as to all easements of support or "beam rights." In case of country property report specifically how boundary lines are evidenced, that is, whether by fences or otherwise). None
8. Is property improved? Yes
9. Indications of building construction, alterations or repairs within recent months: None
(a) If new improvements under construction, how far have they progressed?
10. Changes in street lines either completed or officially proposed: None
(a) Are there indications of recent street or sidewalk construction or repairs?
11. Does the property abut a dedicated public road? If not, explain what type of road it abuts. If property does not abut a road, answer this question "none." Yes
12. If the surveyed premises are subject to restrictive covenants, do the improvements, use and occupancy comply with such? _____
(If the premises are subject to restrictive covenants, have the examining attorney furnish you verbatim copy of them.)

NOTE: In all cases where there are encroachments, support easements, party walls, etc., they should also be denoted upon the map of your survey. Also, be certain map complies with instructions on reverse side.

Registered Land Surveyor

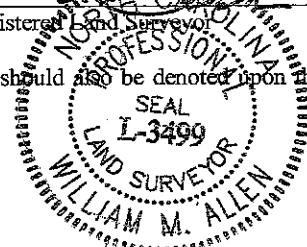

DAS

DON ALLEN & ASSOCIATES, P. A.

"Since 1971"

Commercial * Residential * Mortgage Surveys * Multi-Family

Construction Staking * Subdivision Design * Topographical


127 Promenade Drive - Suite E * Mooresville * NC * 28117

DASSurveying.com * (704) 664-7029 * info@donallensurvey.com

I, certify that this map was drawn under my supervision from an actual survey made under my supervision recorded in deed book 3836, page 0525, and/or plat book 13, page 19, that the ratio of precision is 1":10,000, that this map was prepared in accordance with the General Statutes of North Carolina Chapter 89C.

my hand and seal on the 27TH day of JUNE,
A.D. 2024.

WILLIAM M. ALLEN

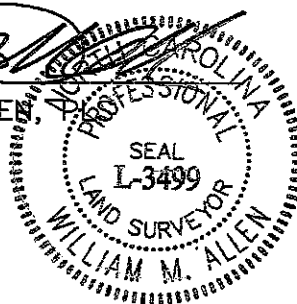

****LAKE NORMAN****



PARCEL#:
461602562128
(0.03 AC.)

760' CONTOUR LINE
LOCATED PER ACTUAL
FIELD SURVEY

NCGS NAD83 (2011)

LOT 27-28
KENDALL
HANKINS NAGY
3782/1181

LINE TABLE		
LINE	BEARING	LENGTH
L1	S 64°41'11" E	49.94'
L2	N 07°53'59" W	40.15'
L3	S 65°14'29" W	9.02'
L4	S 65°14'29" W	5.90'
L5	N 1°27'56" W	57.58'
L6	N 86°26'36" E	46.25'

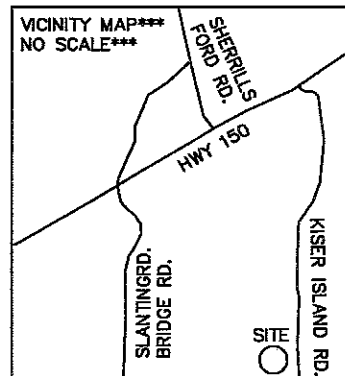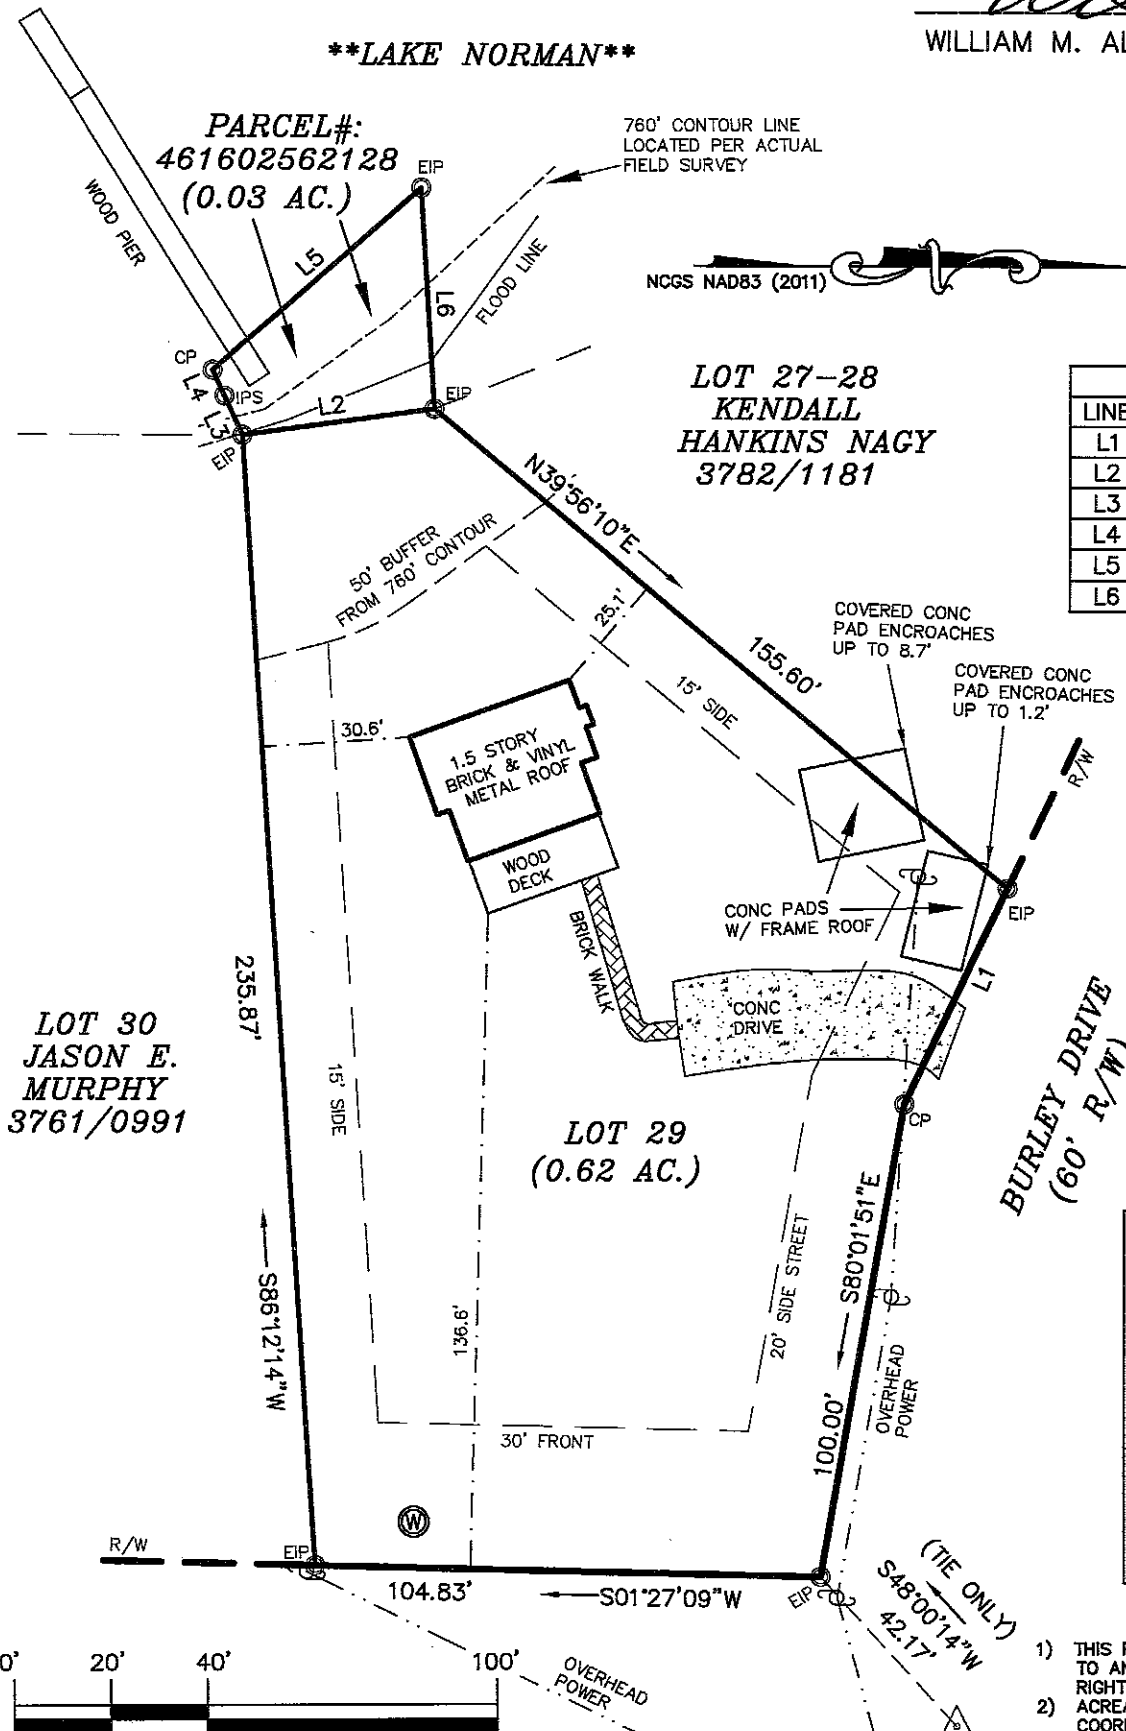

NOTES

- 1) THIS PROPERTY MAY BE SUBJECT TO ANY EASEMENTS AND/OR RIGHTS OF WAY OF RECORD.
- 2) ACREAGE COMPUTED BY THE COORDINATE METHOD.
- 3) OVERHEAD POWER
- 4) NO GRID MONUMENT FOUND WITHIN 2000 FEET.
- 5) SETBACKS SHOWN PER ZONING PROPERTY ZONED: CATAWBA R-30
VERIFY SETBACKS PRIOR TO ANY CONSTRUCTION
- 6) EXISTING 760' & 761' CONTOUR ELEVATION BASED ON LAKE NORMAN LAKE LEVEL AT COWAN'S FORD DAM (READING ON 6/20/2024) ELEVATION: 757.3'

PHYSICAL SURVEY

OF
4673 KISER ISLAND ROAD

LOT 29 B.L. KISER SUBDIVISION NO. 3 & ADDITIONAL PARCEL

MOUNTAIN CREEK TWSP., CATAWBA CO., N.C.

Champak Patel and Suman Patel

FIELD BOOK: 511Z
FILE: BL KISER 29.DWG
TAX MAP NO: 461602563263

SCALE 1" = 40'

ACQUIRED BY:

LEGEND
E.I.P. = EXISTING IRON FOUND
I.P.S. = #4 REBAR SET
CP = COMPUTED POINT
R/W = RIGHT-OF-WAY
P = POWER POLE
W = WELL