

IREDELL COUNTY HEALTH DEPARTMENT

IMPROVEMENT PERMIT / AUTHORIZATION TO CONSTRUCT / OPERATION PERMIT / EXISTING SYSTEM INSPECTION

PERMIT # 5941 PIN# 4646 78 7781 STATESVILLE 704-878-5305 MOORESVILLE 704-664-5281 (930-9445) DATE 10/16/98

OWNER OR CONTRACTOR Clinton Kemp PHONE: Business N/A Home _____

ADDRESS 120-3 JC Cigler / Mooresville, NC. 28115


LOCATION Brow School Rd. to 3rd and after entrance

SUBDIVISION Dubbs Corner BLOCK / SECTION 3 LOT AREA 2.9 AC SITE CLASS. RS DESIGN FLOW 360 L.T.A.R. 3


Septic Tank: <u>1000</u> Gallons; STB <u>714</u> Date <u>1/15/99</u>	☒ New System	☐ Repair System Type: I, II, III, IV, V, VI	☒ House/Mod. Home	No. Bedrooms <u>3</u>	Water Supply: ☒ Individual
Pump Tank: _____ Gallons; PT _____	System Description: <u>Gravity - Conventional</u>		☐ Mobile Home	No. Bathrooms <u>3</u>	☐ Public
Pump Make: _____ Model _____	Repair System Description: <u>None</u>		☐ Business	No. Employees _____	☐ Community
Nitrification Field: No Fields <u>1</u> Square Feet <u>1200</u> Linear Feet <u>400</u>	Maintenance Agreement Required: ☐ Yes ☒ No		☐ Other _____		
No Lines <u>4</u> Trench Width <u>36"</u> Max Trench Bottom Depth <u>36"</u>	Gravel Depth <u>12"</u> ☐ Slab ☒ Crawl Space ☐ Basement w/plumbing ☐ Basement w/plumbing				

Comments/Conditions: _____

INITIAL SITE SKETCH

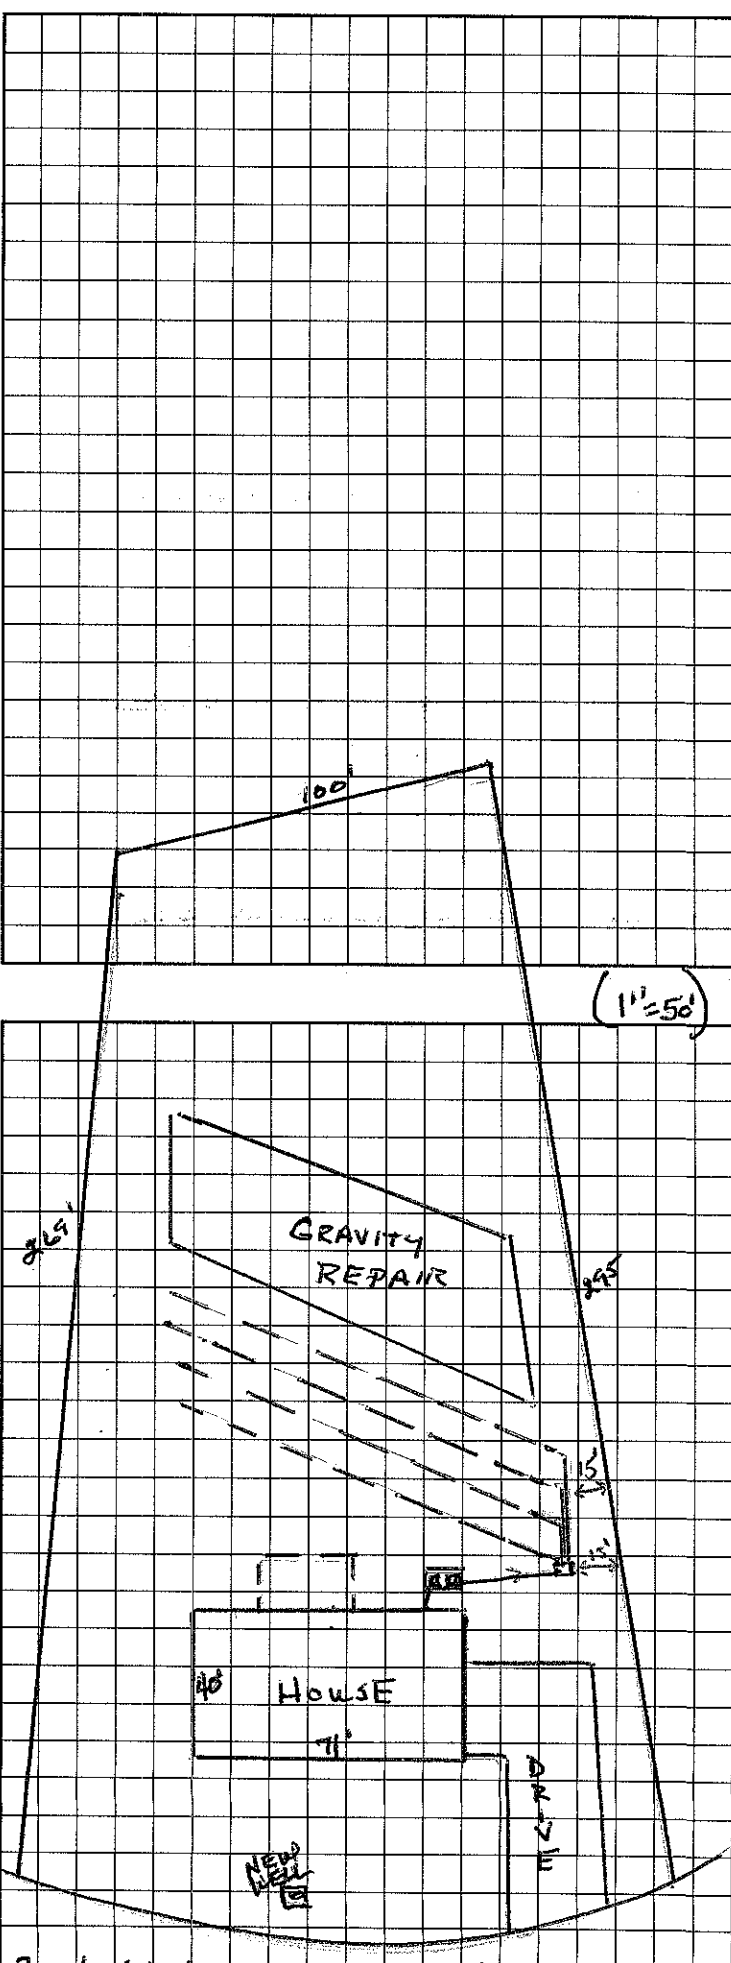

AS BUILT SKETCH

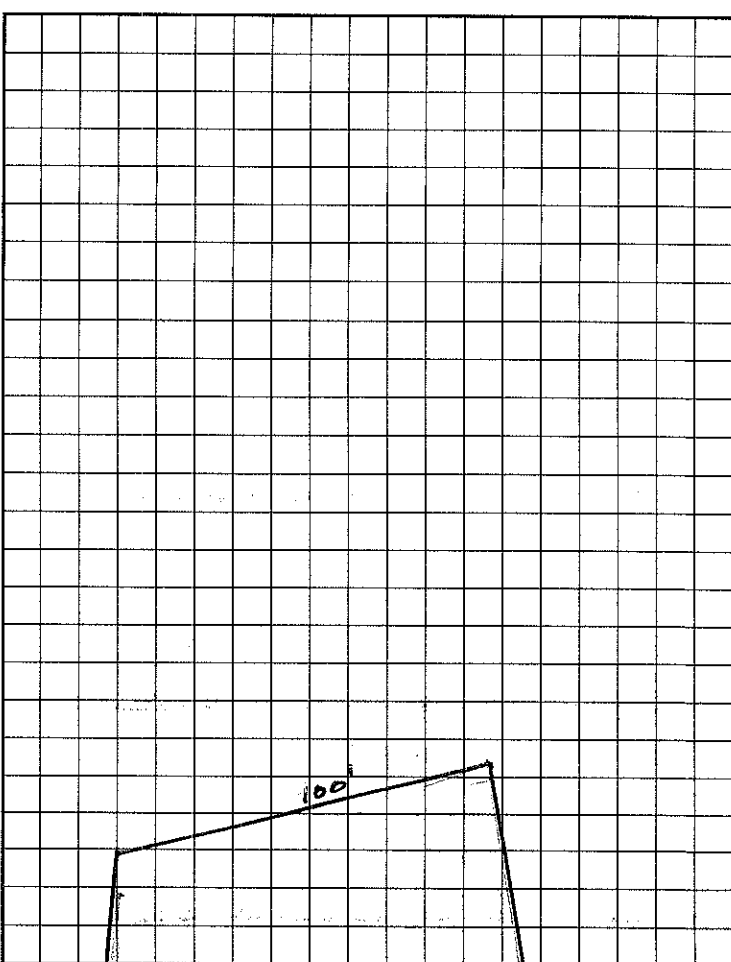

I understand that this permit can be suspended or revoked if any false information is supplied toward securing the permit/any unauthorized changes are made to the site/any unauthorized changes are made in the installation of the system. Improvement Permit with plat valid without expiration. Improvement Permit with site plan valid for sixty months. Authorization to Construct is valid for a period equal to that of Improvement Permit - not to exceed sixty months.

Signed: [Signature] date 10/16/98
 Improvement Permit by: W. G. [Signature] date 10/16/98
 Authorization to Construct by: W. G. [Signature] date 10/16/98
 Installed by: EDDIE BEAN date 3/24/99
 Operation Permit by: C. [Signature] date _____
 Existing System Inspection by: _____ date _____
 OWNER COPY (FINAL): WHITE
 INSPECTION COPY (FINAL): GREEN
 OWNER COPY (INITIAL): PINK
 OWNER COPY (INITIAL): GOLD