

CATAWBA-LINCOLN-ALEXANDER DISTRICT HEALTH DEPARTMENT

HICKORY, N. C.—NEWTON, N. C.—LINCOLNTON, N. C.—TAYLORSVILLE, N. C.
 Phones 328-2561 464-2011 735-3001 632-3101

1973
 Listed

PERMIT TO INSTALL SEPTIC TANK


PERMIT NO. PERMIT DATE March 24, 1972
 Owner Bill Barnett Address #1, Benvue, N.C.
 Tenant Address
 Installed by Richard Armistead Address Denver, N.C.
 Location of Property 3rd St left on Westport - 1st Road
left from panour. on Right.
 Kind of tank in ground Size 1000 Length of trench 20 x 7 1/2 - 16 in

NOTIFY HEALTH DEPARTMENT AT LEAST EIGHT HOURS BEFORE TANK IS TO BE INSPECTED

Final Inspection March 24, 1972 Approved [Signature] Disapproved ()

Remarks: Public Water

Westport 3rd St 2 W North
 First five feet of line from outlet house should be of cast iron soil pipe.

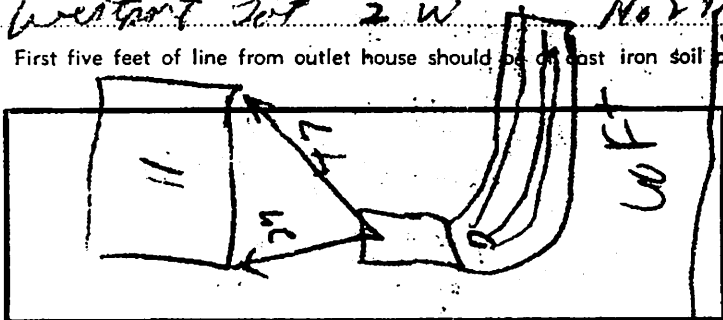

Sketch of tank and line showing distance from dwelling and well on subject property and on adjoining property.

[Signature]
 Sanitarian