

Tax Code
9-408-010

SEWAGE DISPOSAL SYSTEM PERMIT Number 90-218
This Permit Expires One Year From Date Issued

Date Issued 4-18-90

This permit is issued by the Union County Health Department to construct and install the work hereby described. The construction shall be made in compliance with the N.C. Division of Health Services Laws and Rules for Ground Absorption Sewage Treatment and Disposal Systems and Union County Health Department Rules and Regulations.

JOB ADDRESS/LOCATION Clarence Secret Rd - Weddington Tidge - Lot #17 Block 1 Hwy 84 to Weddington Rd, appx. 4 miles to Willoughby Rd. on the left, go appx. 1/4 mile on left to Clarence Secret Rd. Weddington Tidge on R

Owner Don S. Simpson Mailing address 1026 Tioanoke Ch. Rd. City Monroe State NC Zip 28110 Phone 283-8861

Installation for: House ☒ Apt. House ☐ Ind/Commercial ☐ Trailer Park ☐ Mobile Home ☐

Lot size: 0.92 acres Number of living units 1 Number of bedrooms 3 Garbage grinder: yes ☐ no ☒

Water Supply: Public system name County water Private ☐ Approved zoning type RA-40 Watershed name

Soil character to depth of 3 feet: sand ☐ clay ☒ sandy loam ☐ clay loam ☐ silt loam ☐ Other ☐

Soil performance criteria: (Suitable, Provisionally suitable, Unsuitable): Permeability PS Slope/grade PS

Restrictive soil layers: PS Water table Soil depth PS Area PS

Plot plan, showing size of lot, location of system in relation to wells, buildings, etc. on reverse side.

NEW INSTALLATION: (No individual sewage disposal system permitted within 200 feet of public sewer.)

Septic tank ☒ Size Capacity 1000 gal Number of compartments 2
Pump tank ☐ Size Capacity Pump flow, g/p.m. Tot. dyn. head
Distance to nearest well 100' Waterline 10' Foundation 10' Property line 10'

LPP
Nitrification line ☒ No. lines 4 Trench width 36" Sq. ft. 1200 D-box ☒ Filter mat./depth 12" of #5 stone
Distance to nearest well 100' Waterline 10' Foundation 10' Property line 10'

REPAIR/ADDITION Previous sewage disposal system permit number Dated

LPP
Septic tank ☐ Size Capacity Number of compartments

Nitrification line ☐ No. lines Trench width Sq. ft. D-box ☐ Filter mat./depth
Pump tank ☐ Capacity Pump flow Total dynamic head


I hereby certify that this application has been prepared and the work will be done in accordance with the Union County Ordinances, State Laws, Rules and Regulations of the Union County Health Department.

Notice: The issuance of this permit does not relieve the property owner of this responsibility for checking his proposed development with applicable zoning regulations.

Signed Nancy J. Carver

Permit prepared by Jim Palmer Date prepared: 3/6/90 Comments: Permit Designed
Final inspection by: Mr. Newell RS Date of inspection: 10/30/90
Contractor: Williams Septic Tank Co.

UNION COUNTY HEALTH DEPARTMENT

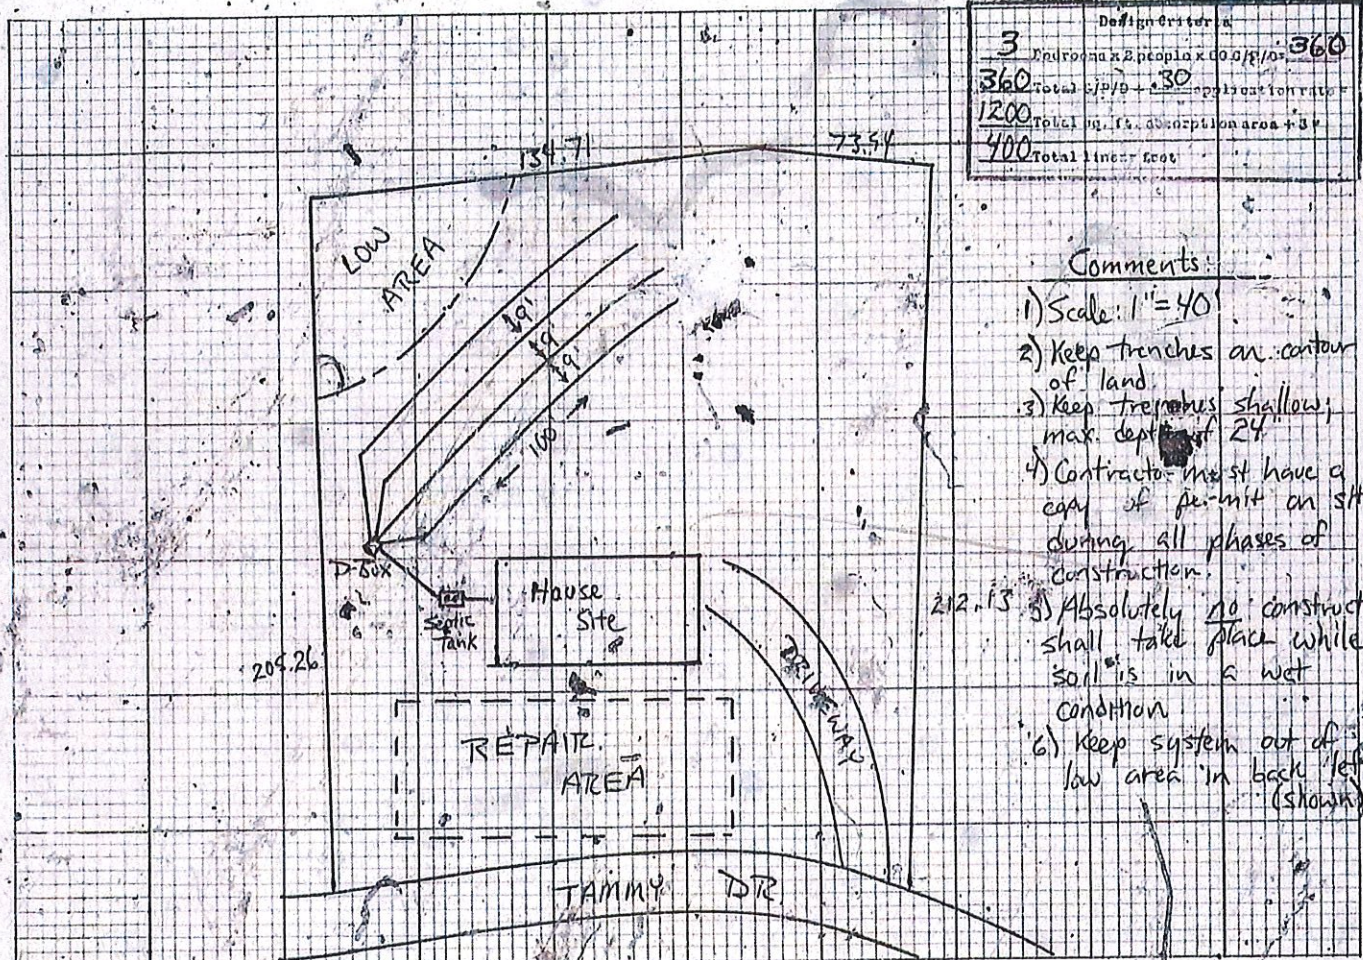

Comments:

- 1) Scale: 1" = 40'
- 2) Keep trenches on contour of land.
- 3) Keep trenches shallow; max. depth of 24"
- 4) Contractor must have a copy of permit on site during all phases of construction.
- 5) Absolutely no construction shall take place while soil is in a wet condition.
- 6) Keep system out of low area in back left (shown).